




A - A

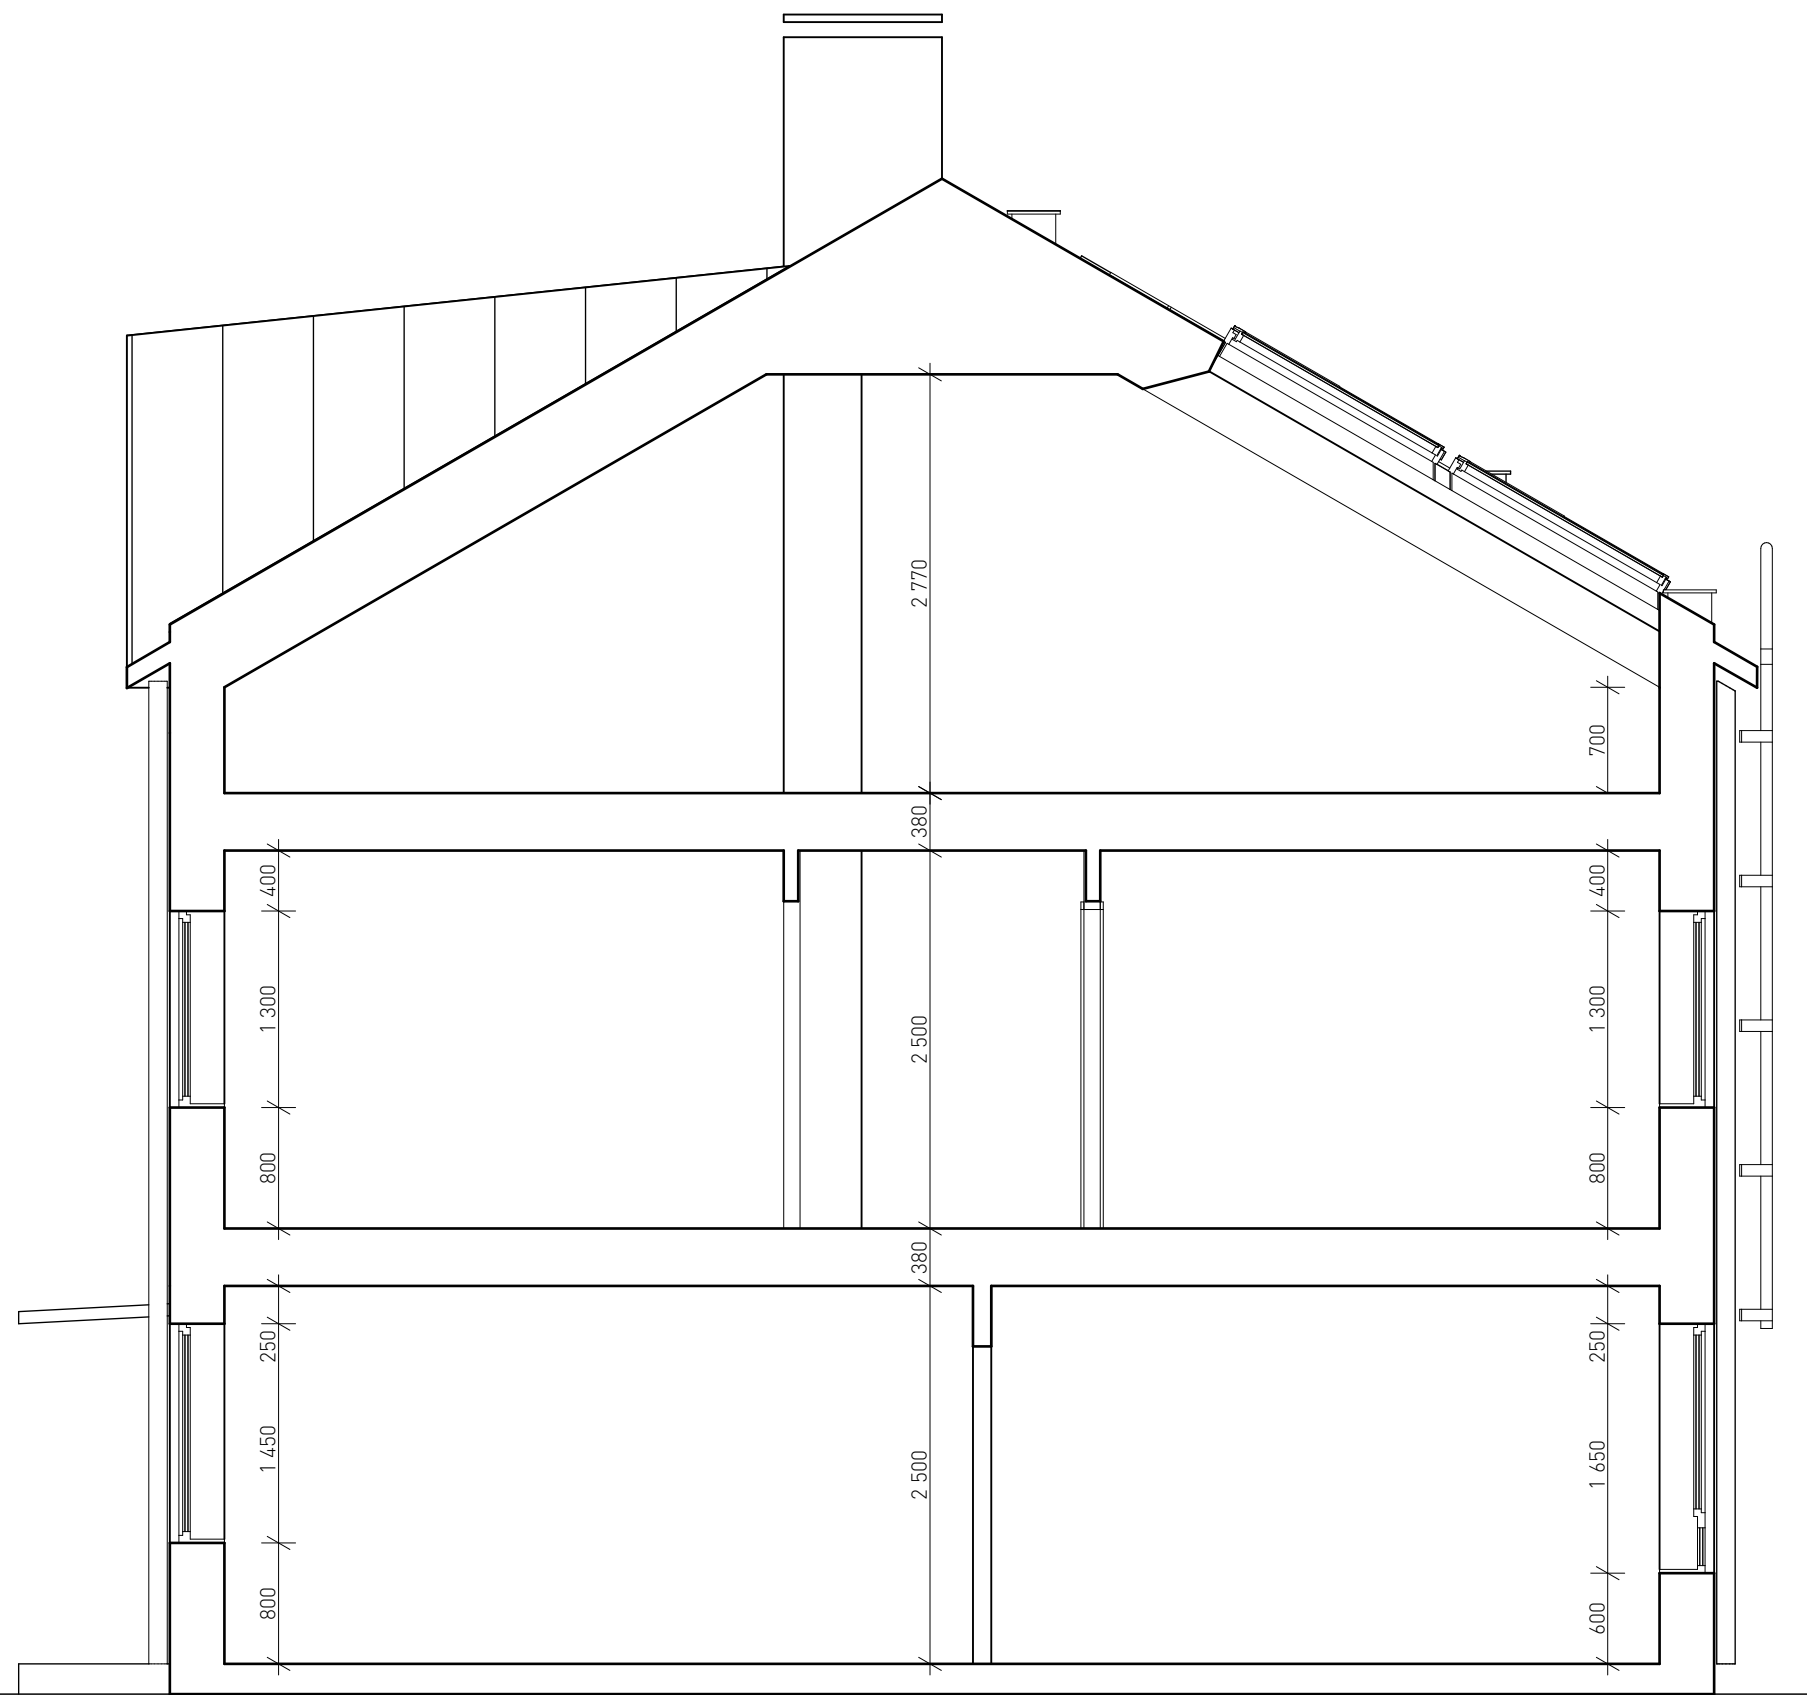


B - B

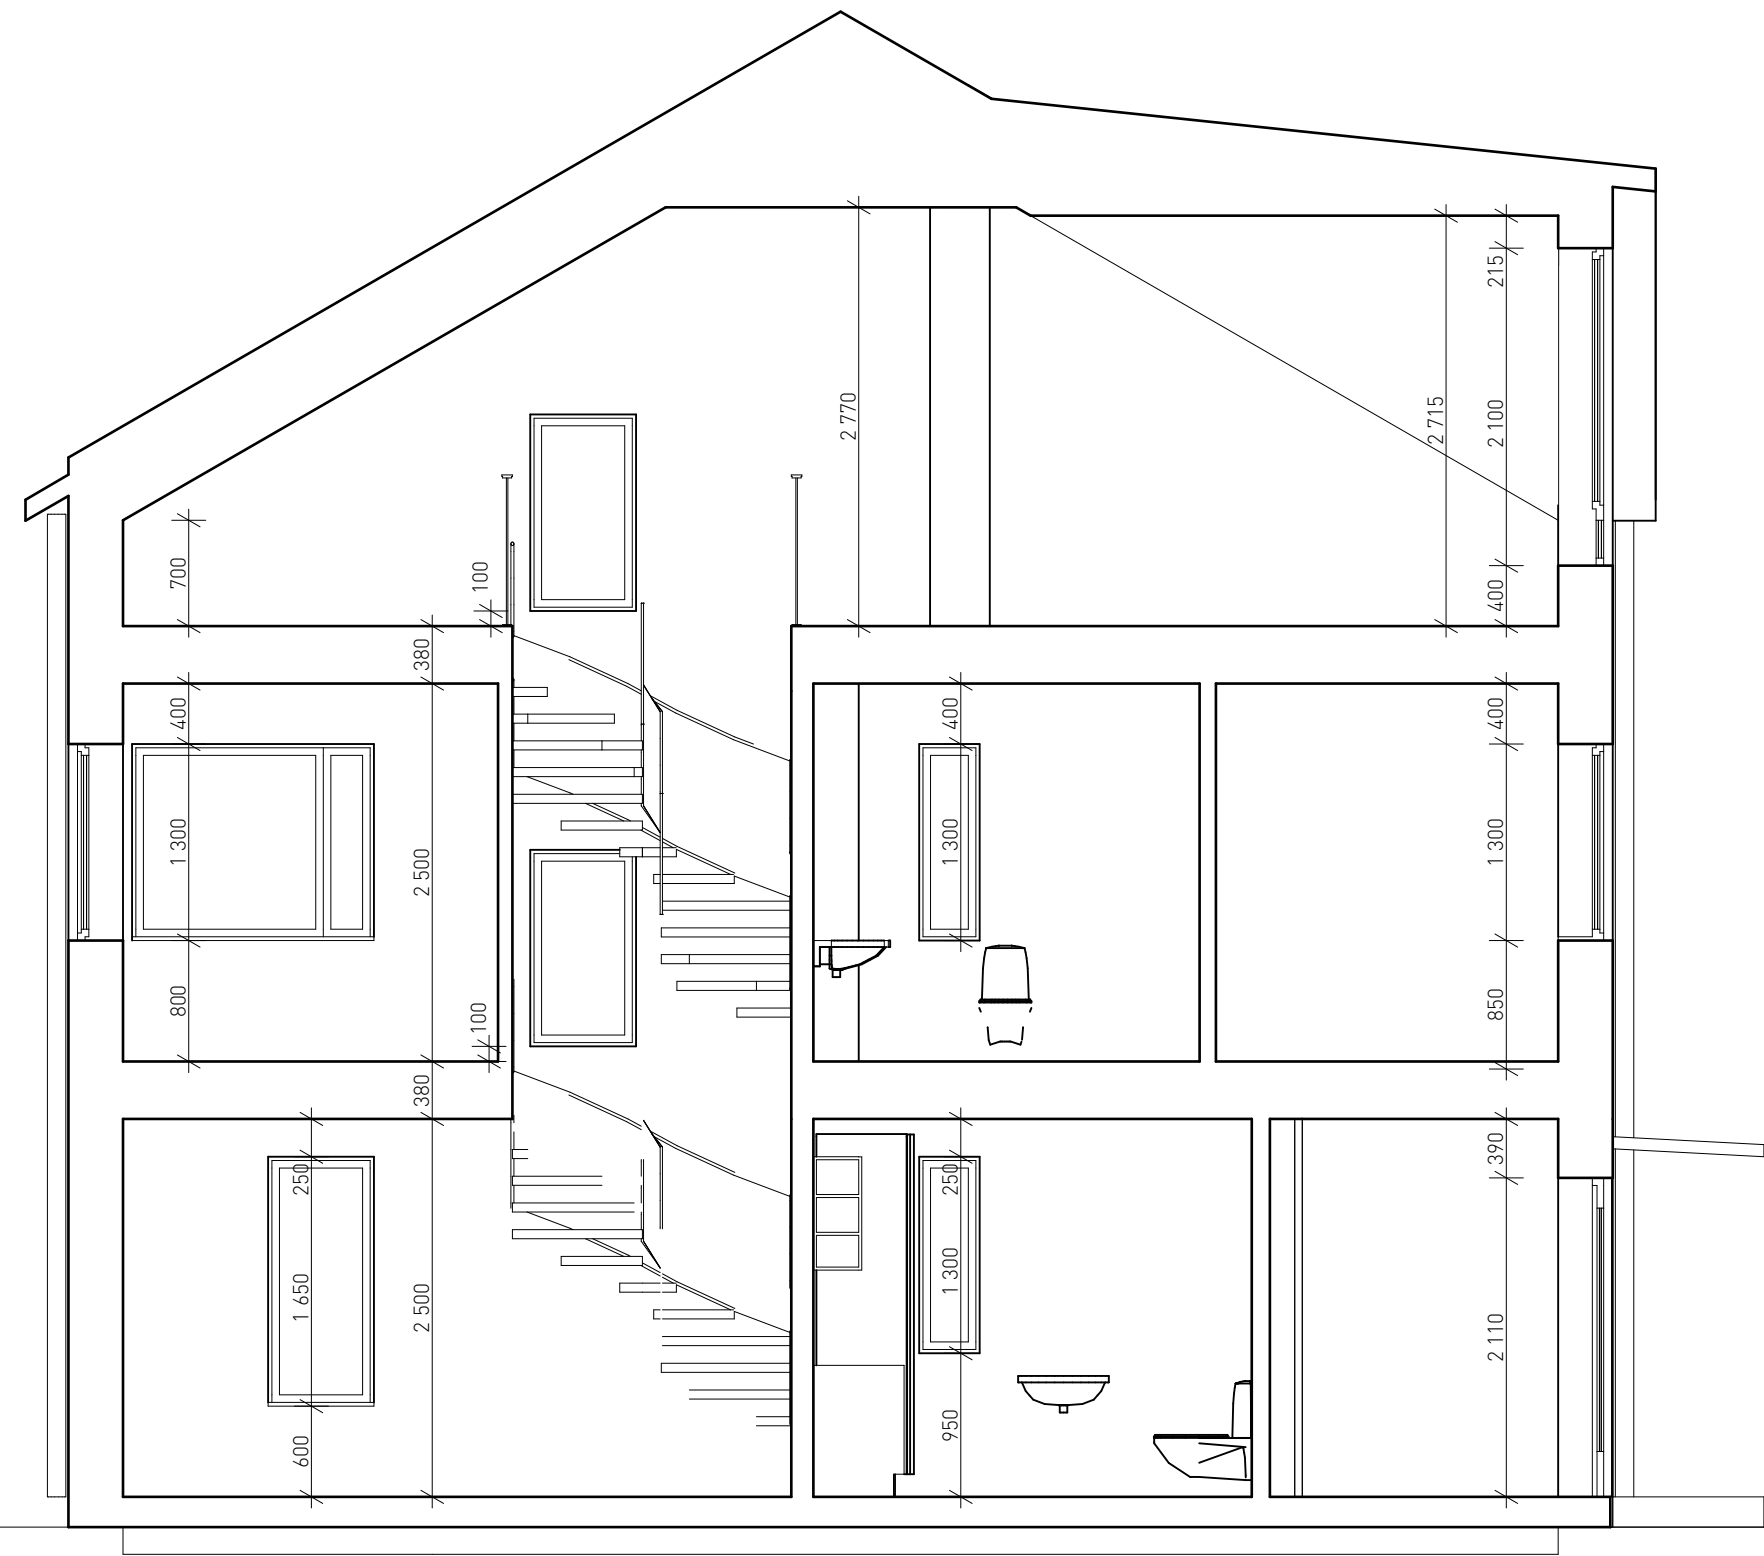

C - C

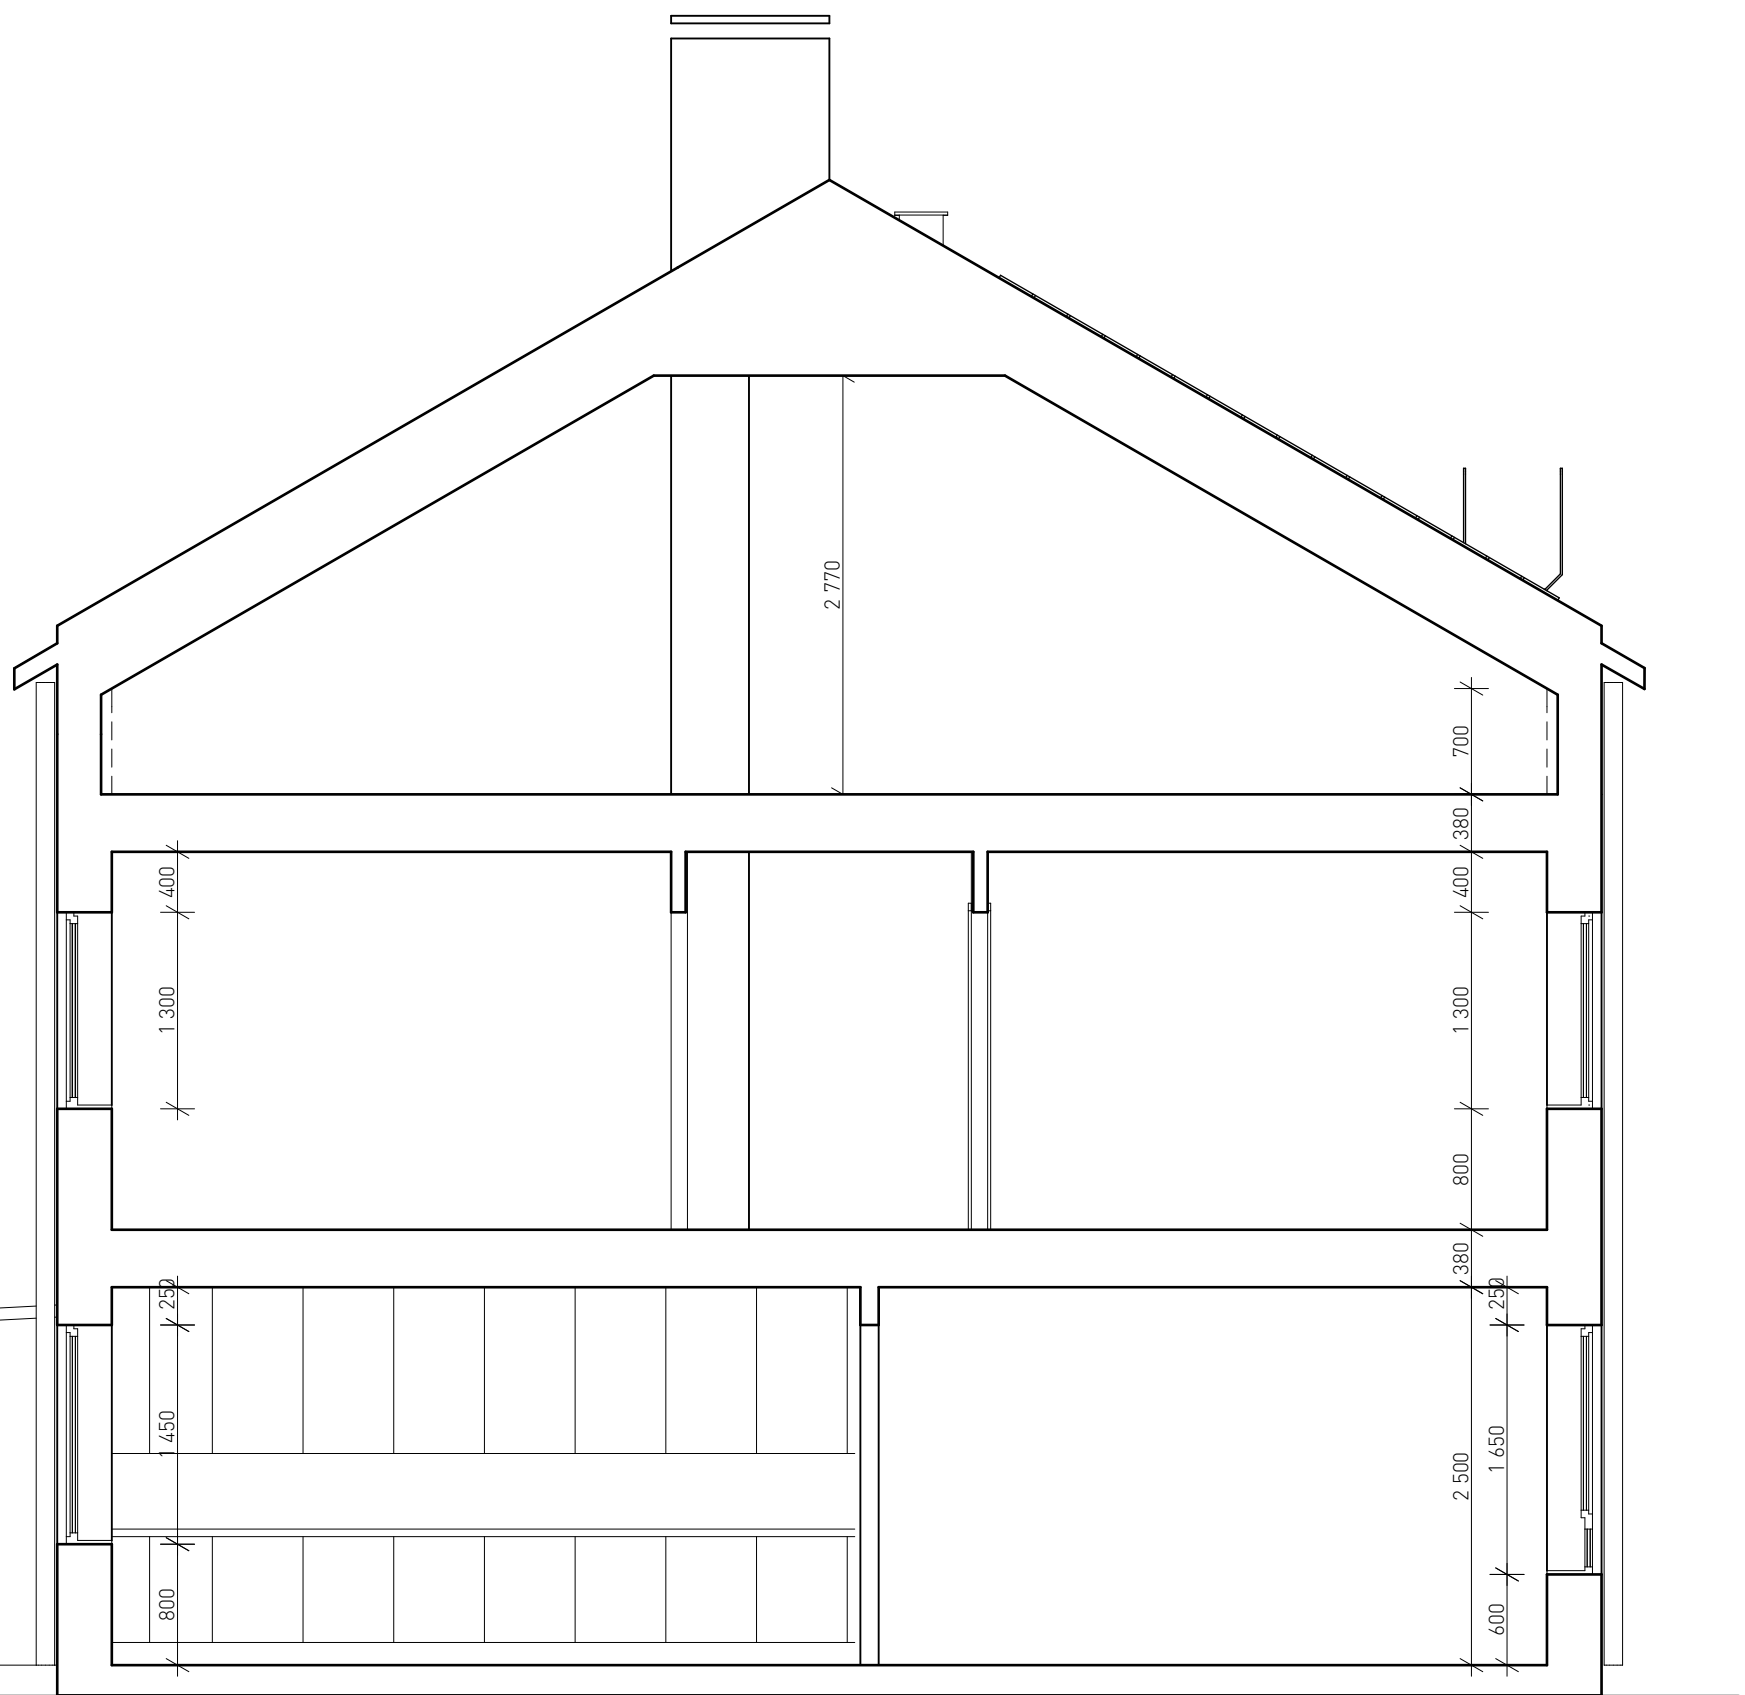

D - D

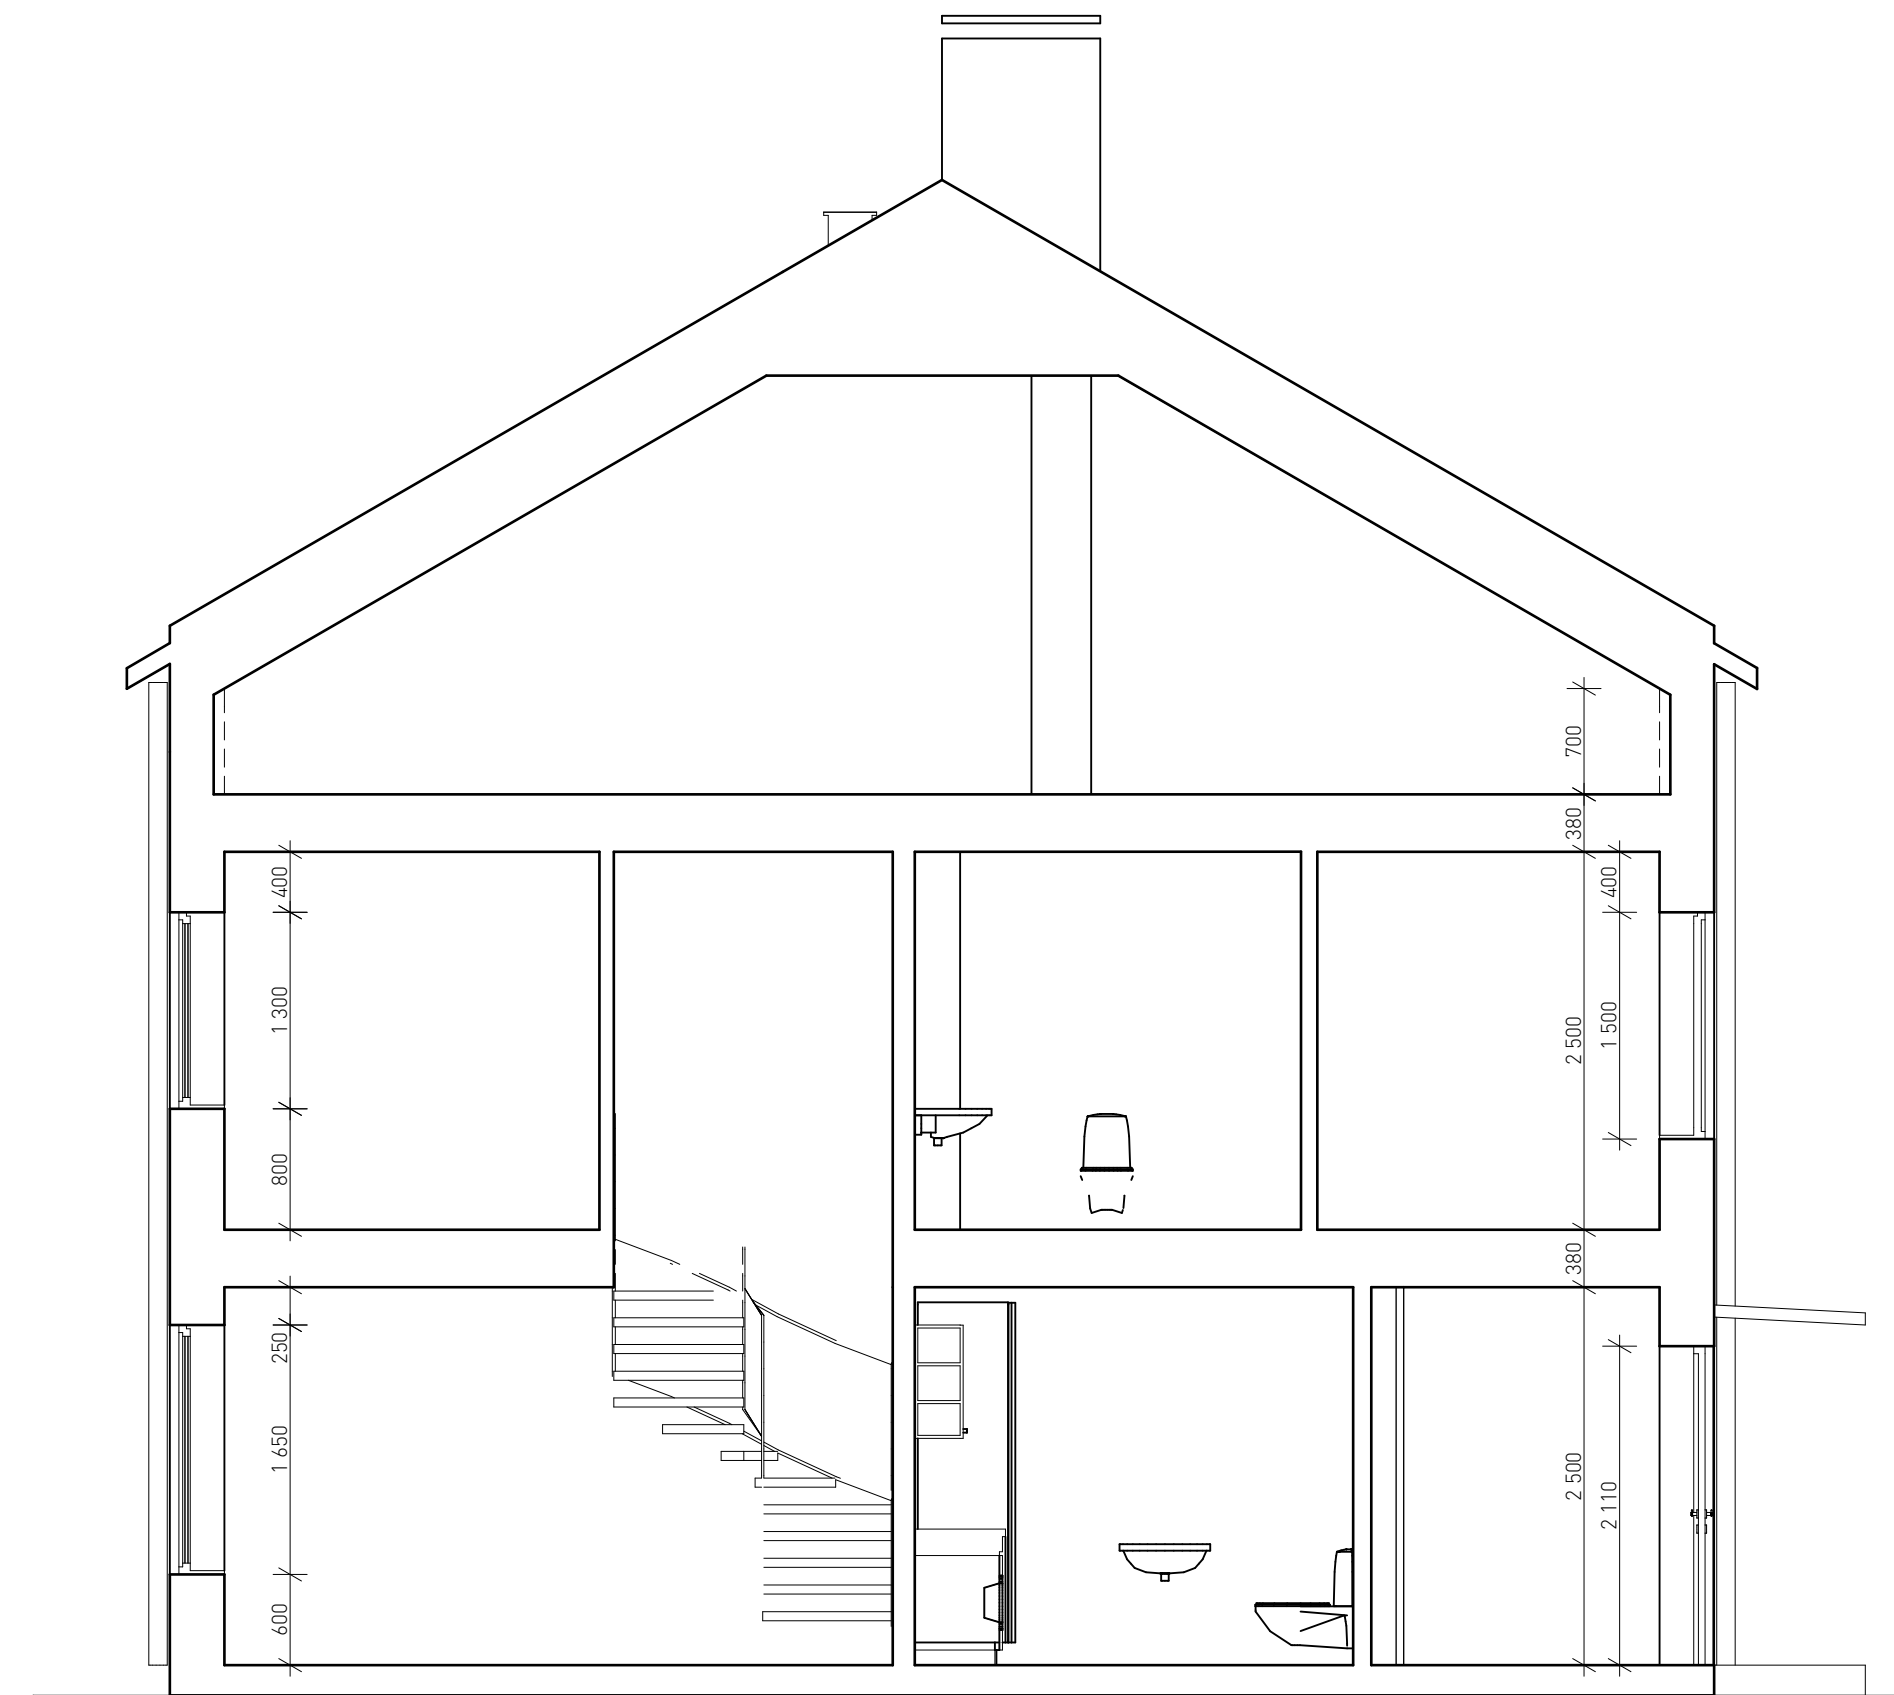

E - E

BET	ANT	ÄNDRINGEN AVSER	DATUM	SIGN
RELATIONSHANDLING				
LÅNGBRODAL				
		NCC Construction Sverige AB Region Boende Stockholm 170 80 Solna (besök: Vallgatan 3) tel 08-555 510 00 www.ncc.se		
	Brunnberg & Forshed		Tel: 08-617 61 00 Fax: 08-650 19 81 e-post: n.f@brunnbergforshed.se	
	ÄWL		Tel: 08-555 786 37 Fax: e-post:	
	WSP		Tel: 08-545 228 09 Fax: e-post:	
	Briab		Tel: 08-410 102 58 Fax: e-post:	
	Ingemansson		Tel: 010-505 60 37 Fax: e-post:	
	Totalkonsult		Tel: 034-68 14 20 Fax: e-post:	
UPPDRAG NR NCCS 0135		RITAD AV / KONSTR AV		HANDLÄGGARE IM
DATUM 111117		ANSVARIG ANN-CHRISTIN OHLANDER		
Sektioner				
SKALA A1 1:50		NUMMER A306-21		BET